

EXISTING DISTRIBUTION (DB-COM) BOARD TO BE REMOVED AND DECOMMISSIONED ALLOW TO PROVIDE NEW DISTRIBUTION (DB-SB) BOARD, MODIFY / EXTEND & RE-TERMINATE EXISTING INCOMING SUB-MAINS AND PROVIDE NEW SUB-CIRCUITS.


ENSURE ALL EXISTING CABLING FOR REUSE ARE TESTED (INSULATION RESISTANCE AND MEGGER) PRIOR TO ENERGISATION. WHERE CABLES FAIL TEST, ALLOW TO SUPPLY AND INSTALL NEW.

EXISTING COMMUNICATIONS RACK SHALL REMAIN, MODIFY AS REQUIRED TO SUIT NEW WORKS.

EXISTING DB-BB TO REMAIN.

EXISTING 750KVA TRANSFORMER TO REMAIN.

EXISTING MSB-N TO REMAIN. CONTRACTOR TO CONFIRM SIZE OF EXISTING CIRCUIT BREAKER WITHIN THE MSB FEEDING DB-BB.

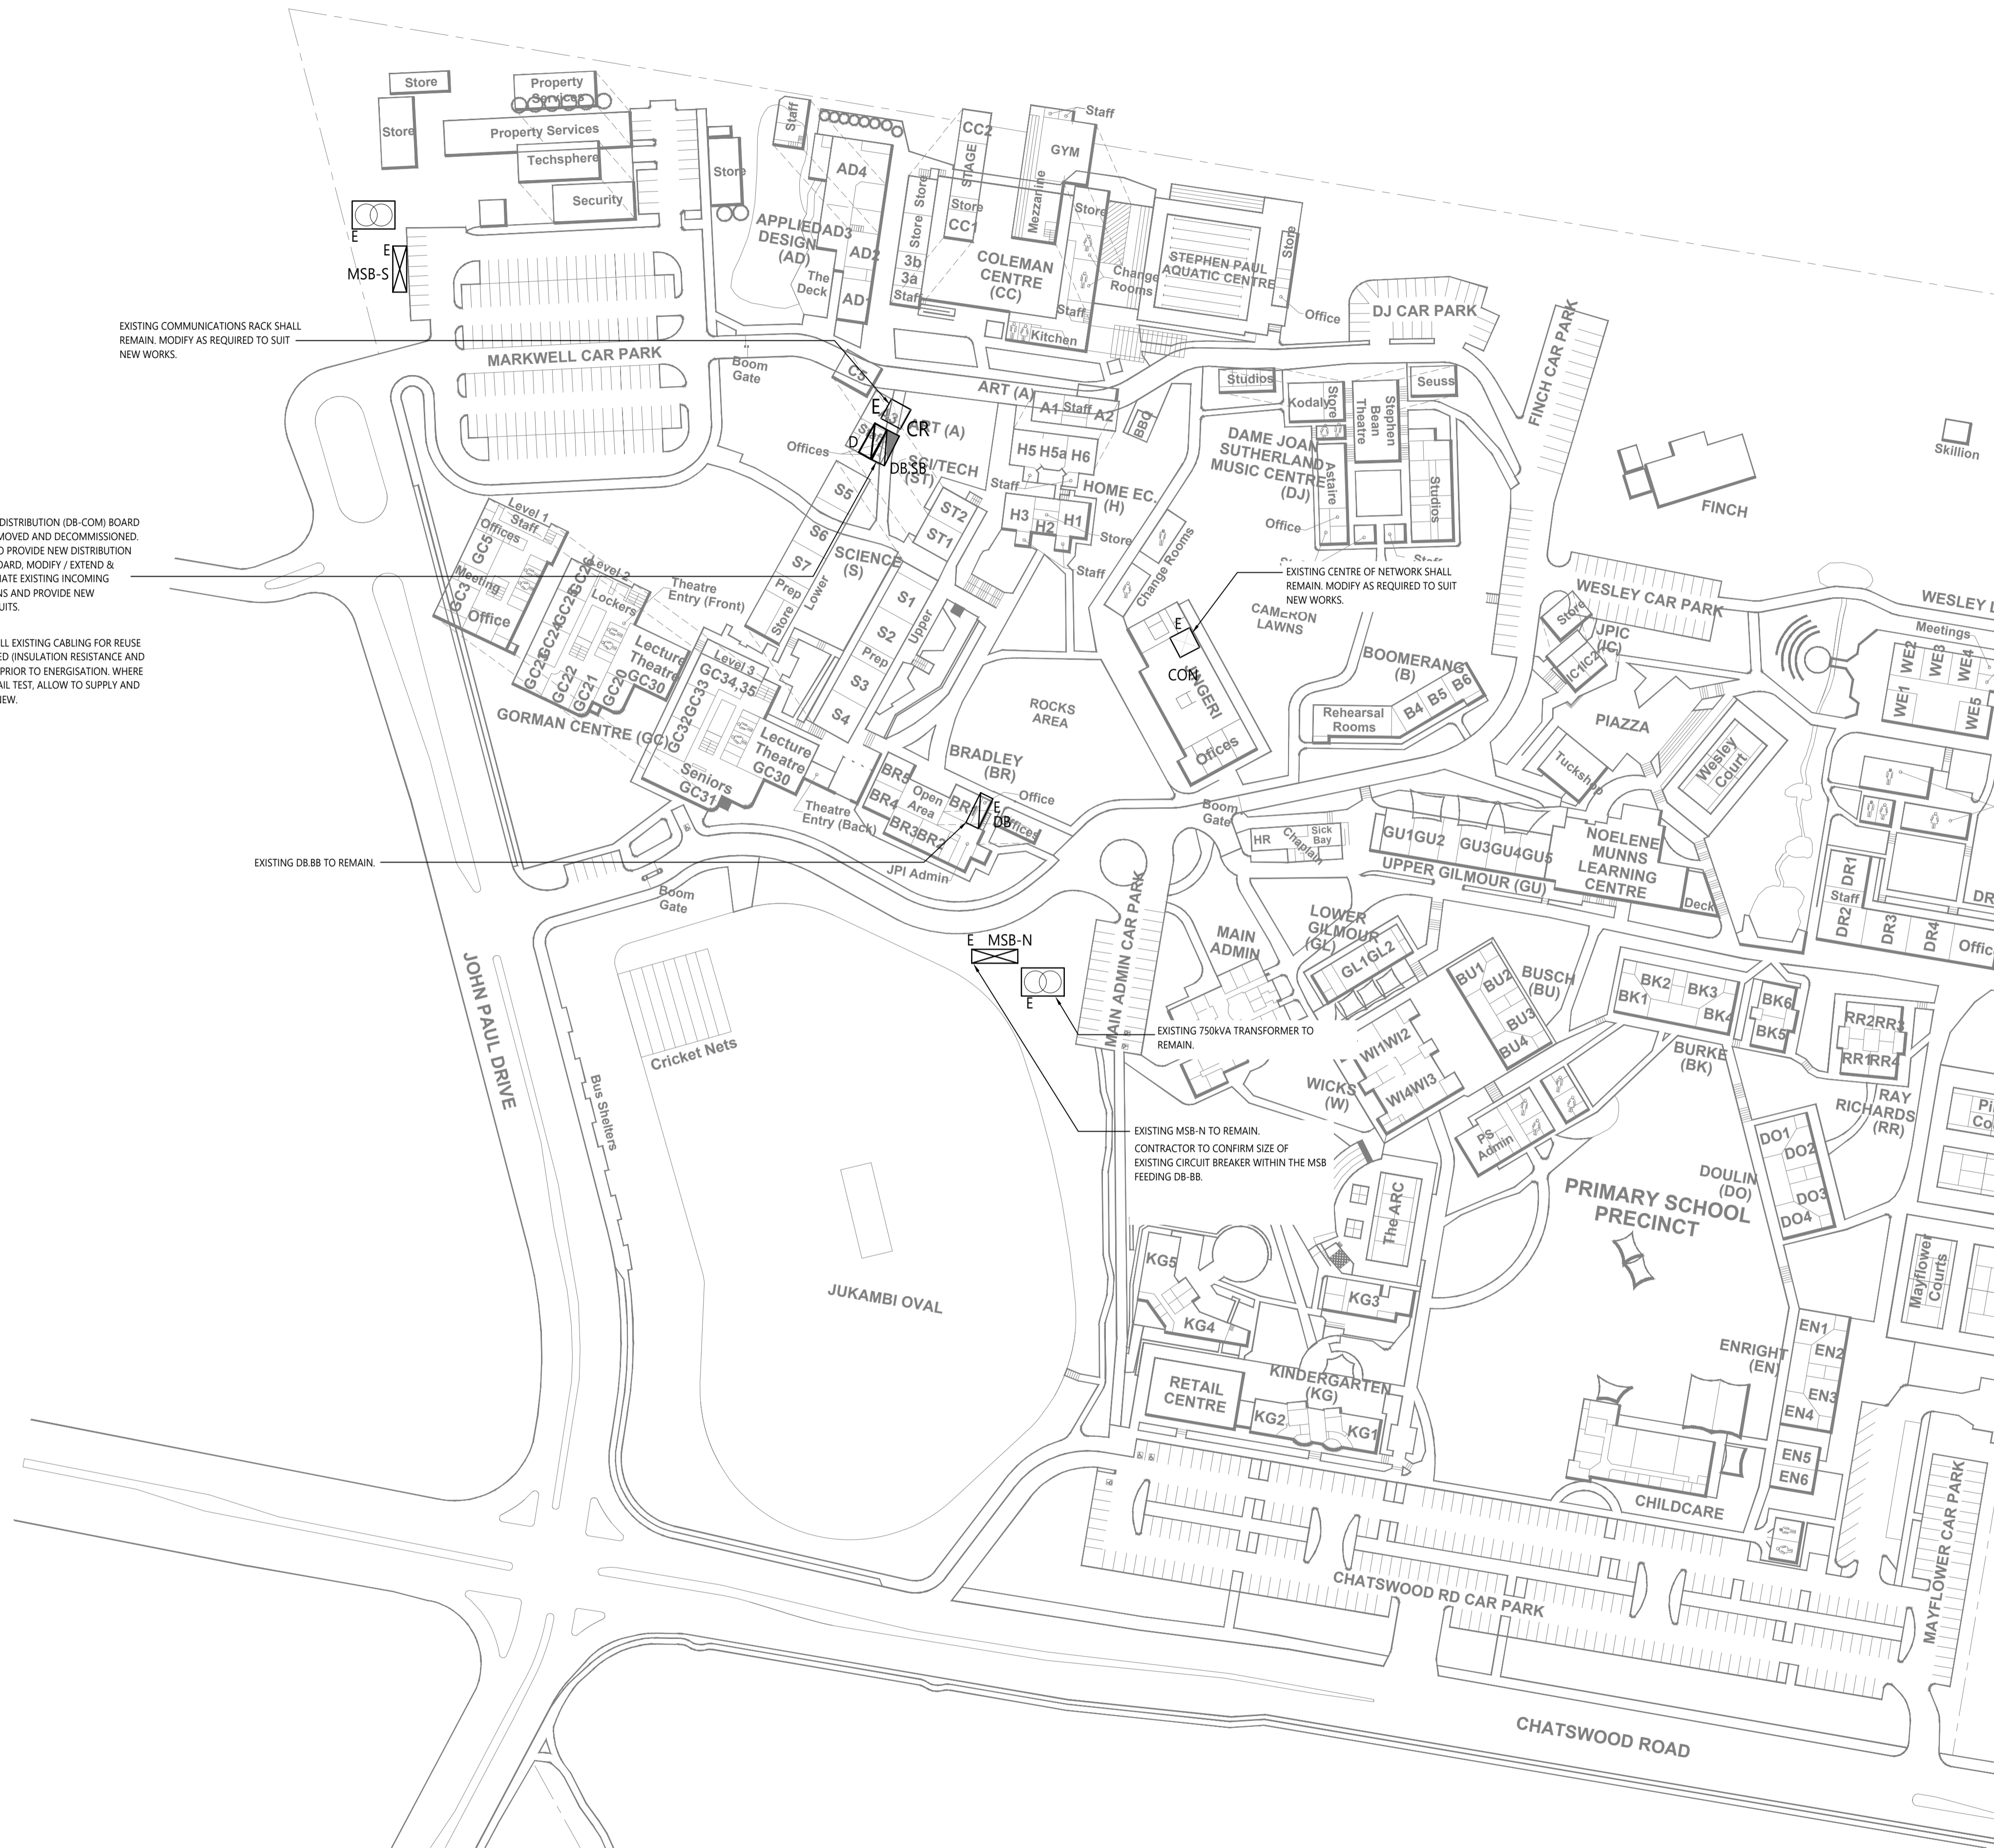

ELECTRICAL DESIGN GROUP BRISBANE PTY LTD
ACN 092 710 793
TRADING AS:
ELECTRICAL DESIGN GROUP

THE COPYRIGHT OF THIS DRAWING REMAINS THE PROPERTY OF THE ELECTRICAL DESIGN GROUP.
USE FIGURED DIMENSIONS IN PREFERENCE TO SCALE.
ALL DIMENSIONS TO BE VERIFIED ONSITE.



E: info@aswelectrical.com.au
M: 0450 440 569
www.aswelectrical.com.au

ELECTRICAL DESIGN GROUP
ELECTRICAL BUILDING SERVICES CONSULTANTS
BRISBANE GOLD COAST

P.O. Box 15, Sherwood Q.4075
Phone: (07) 3278 4375
Email: brisbane@edg.net.au
Web: www.edg.net.au

PROJECT:
**JOHN PAUL COLLEGE
SCIENCE CLASSES**

125 JOHN PAUL DRIVE, DAISY HILL, QUEENSLAND

B	AS CONSTRUCTED	14/01/2025
REV:	DESCRIPTION:	DATE:

DRAWING:
**ELECTRICAL SERVICES
SITE PLAN**

SCALE: 1:1000	AT A1	PROJECT NO: C3406a	DRAWING NO: E03	REVISION: B
------------------	-------	------------------------------	---------------------------	-----------------------