


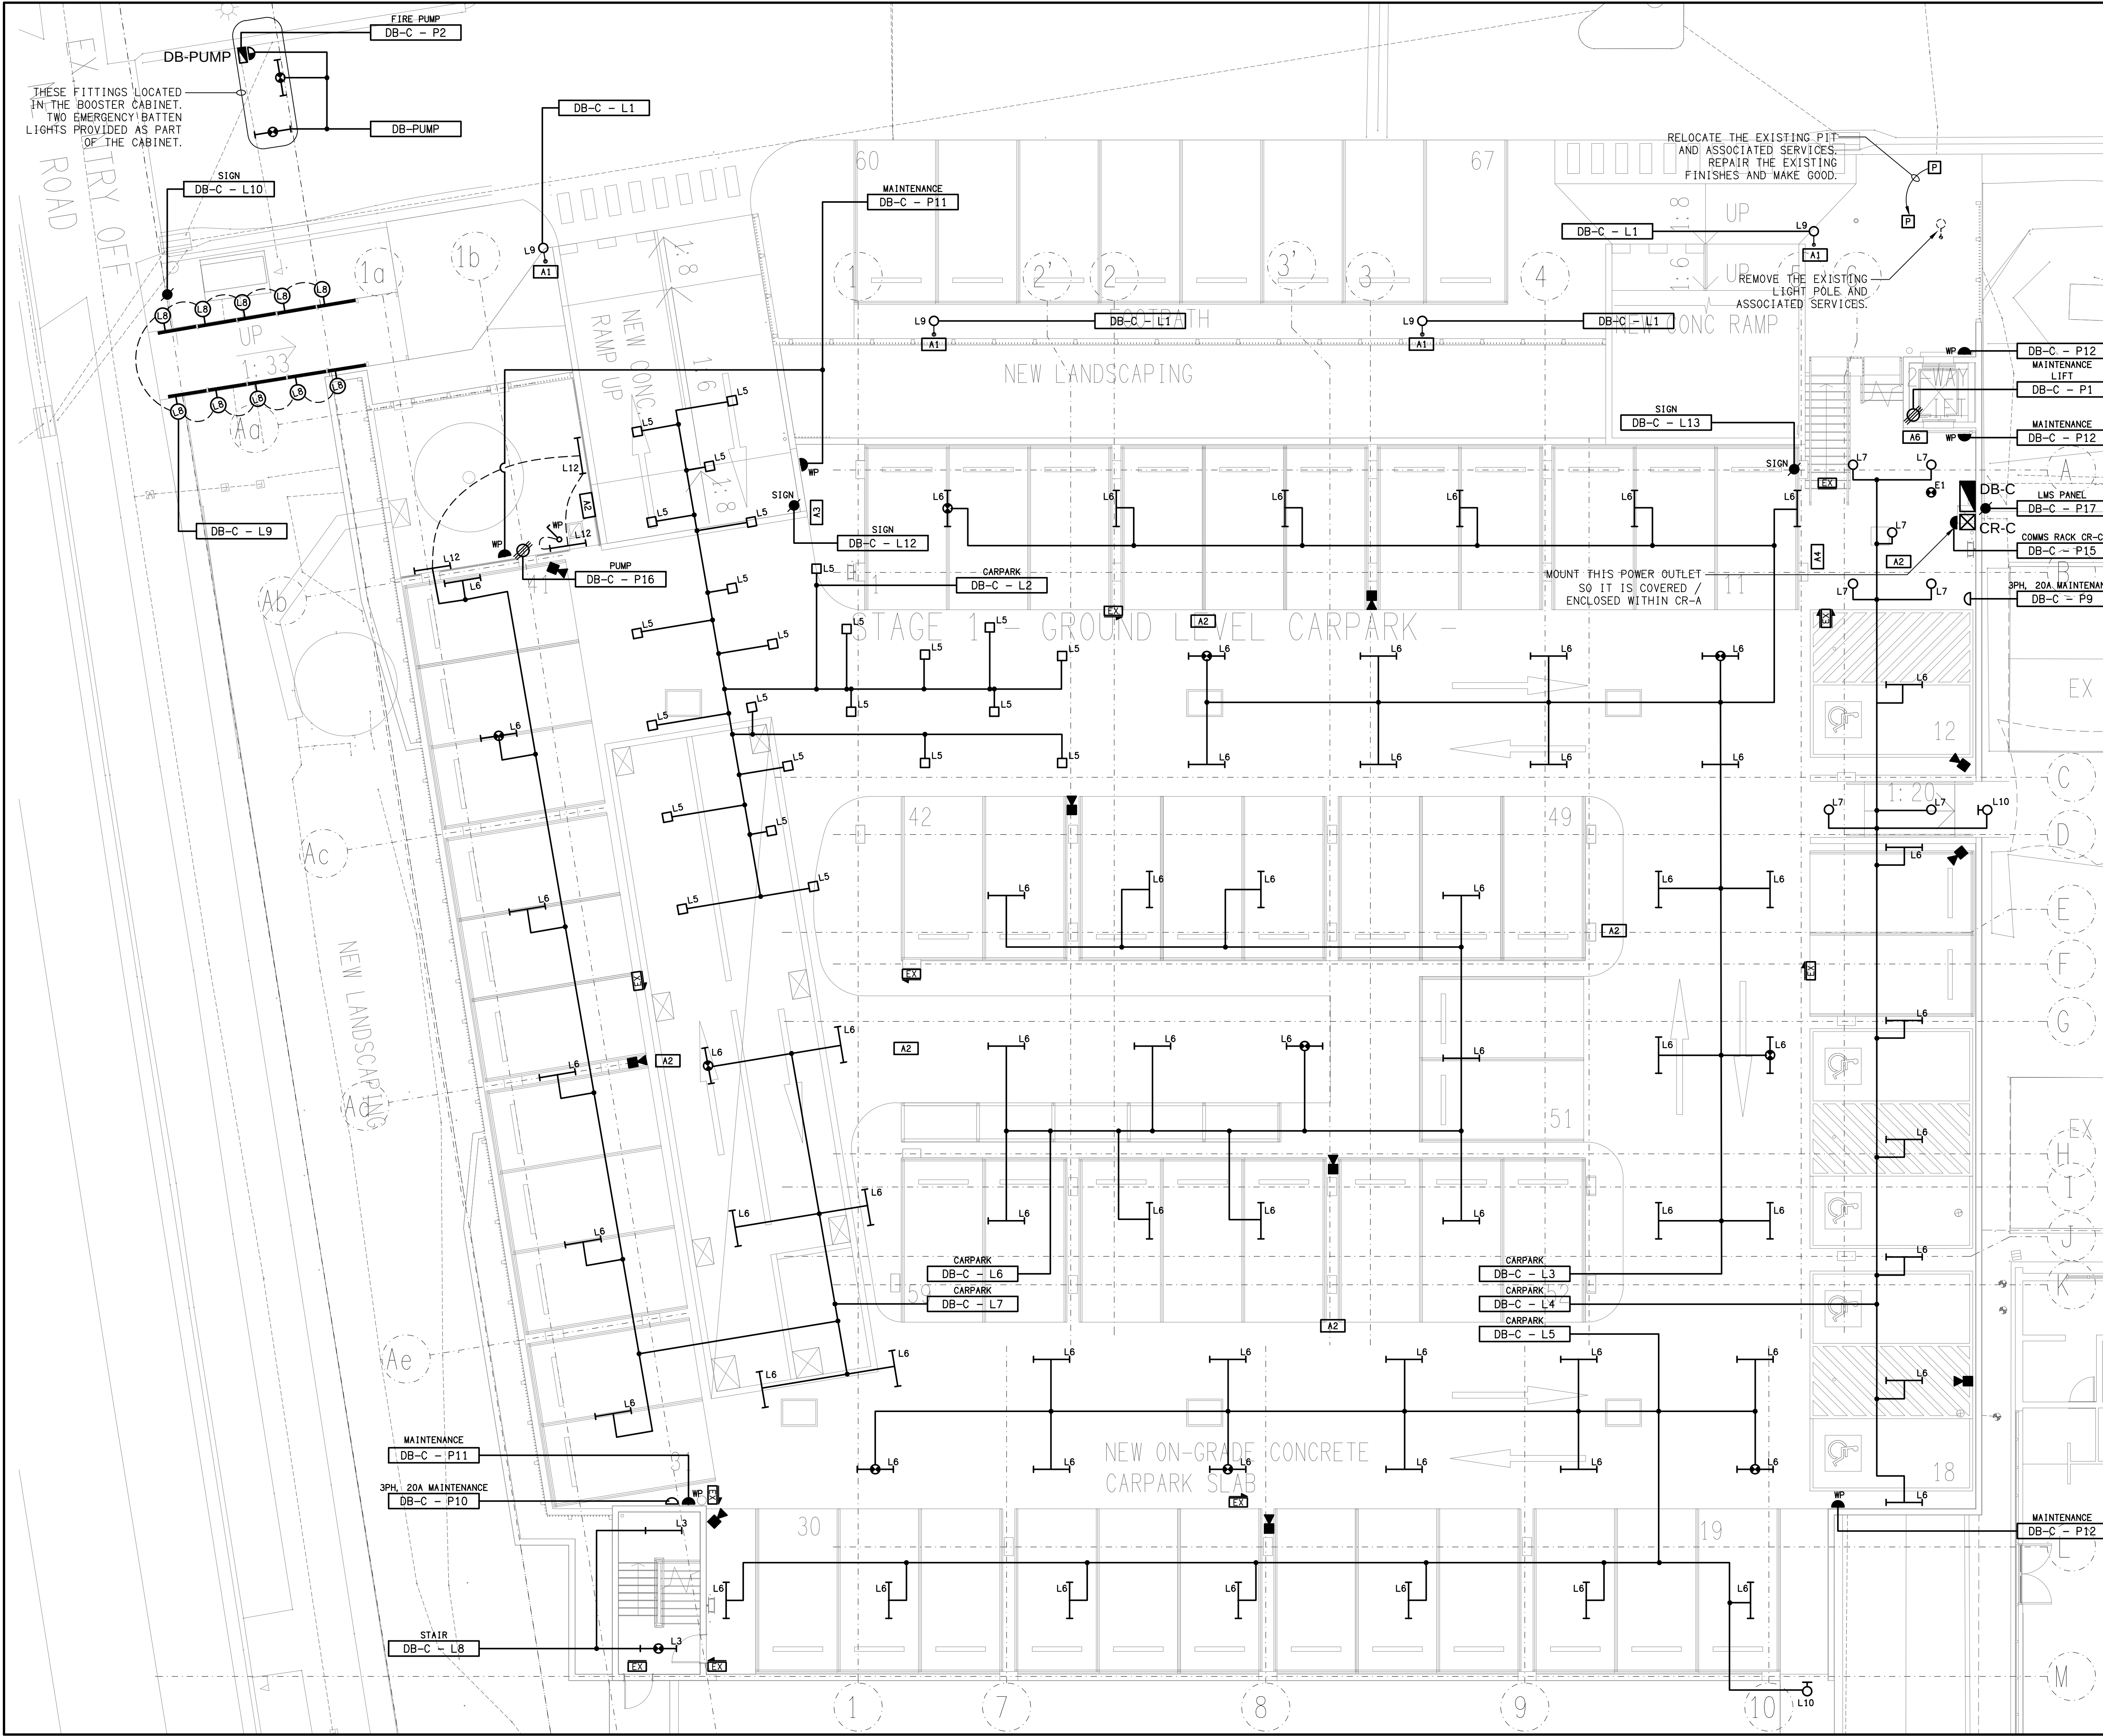

THE COPYRIGHT OF THIS DRAWING REMAINS THE PROPERTY OF THE ELECTRICAL DESIGN GROUP.

USE FIGURED DIMENSIONS IN PREFERENCE TO SCALE.

ALL DIMENSIONS TO BE VERIFIED ONSITE.

wfmelectrical.com.au
07 3274 2558
Facebook, Instagram, LinkedIn icons

Qld Elec Contractors Lic: 8508
NSW Elec Contractors Lic: 351039C
AECN: 30 000 634 008

L	AS CONSTRUCTED	26/08/2026
REV:	DESCRIPTION:	DATE:

ELECTRICAL DESIGN GROUP
ELECTRICAL BUILDING SERVICES CONSULTANTS

BRISBANE: P.O. Box 15 Sherwood Qld 4075
Phone: (07) 3278 4375
Email: brisbane@edg.net.au
Web: www.edg.net.au

ELECTRICAL DESIGN GROUP BRISBANE PTY LTD
ACN 092 710 793

TRADING AS:
ELECTRICAL DESIGN GROUP

PROJECT:

**CAPALABA SPORTS CLUB
MULTI-STOREY CARPARK**

SITE ADDRESS:

113 NEY ROAD, CAPALABA

SCALE: 1:100 UNO

SHEET SIZE: AT A1

DRAWING TITLE:

**ELECTRICAL SERVICES
GROUND LEVEL PLAN**

PROJECT NO: DRAWING NO: REVISION:

C3455a E02 L