


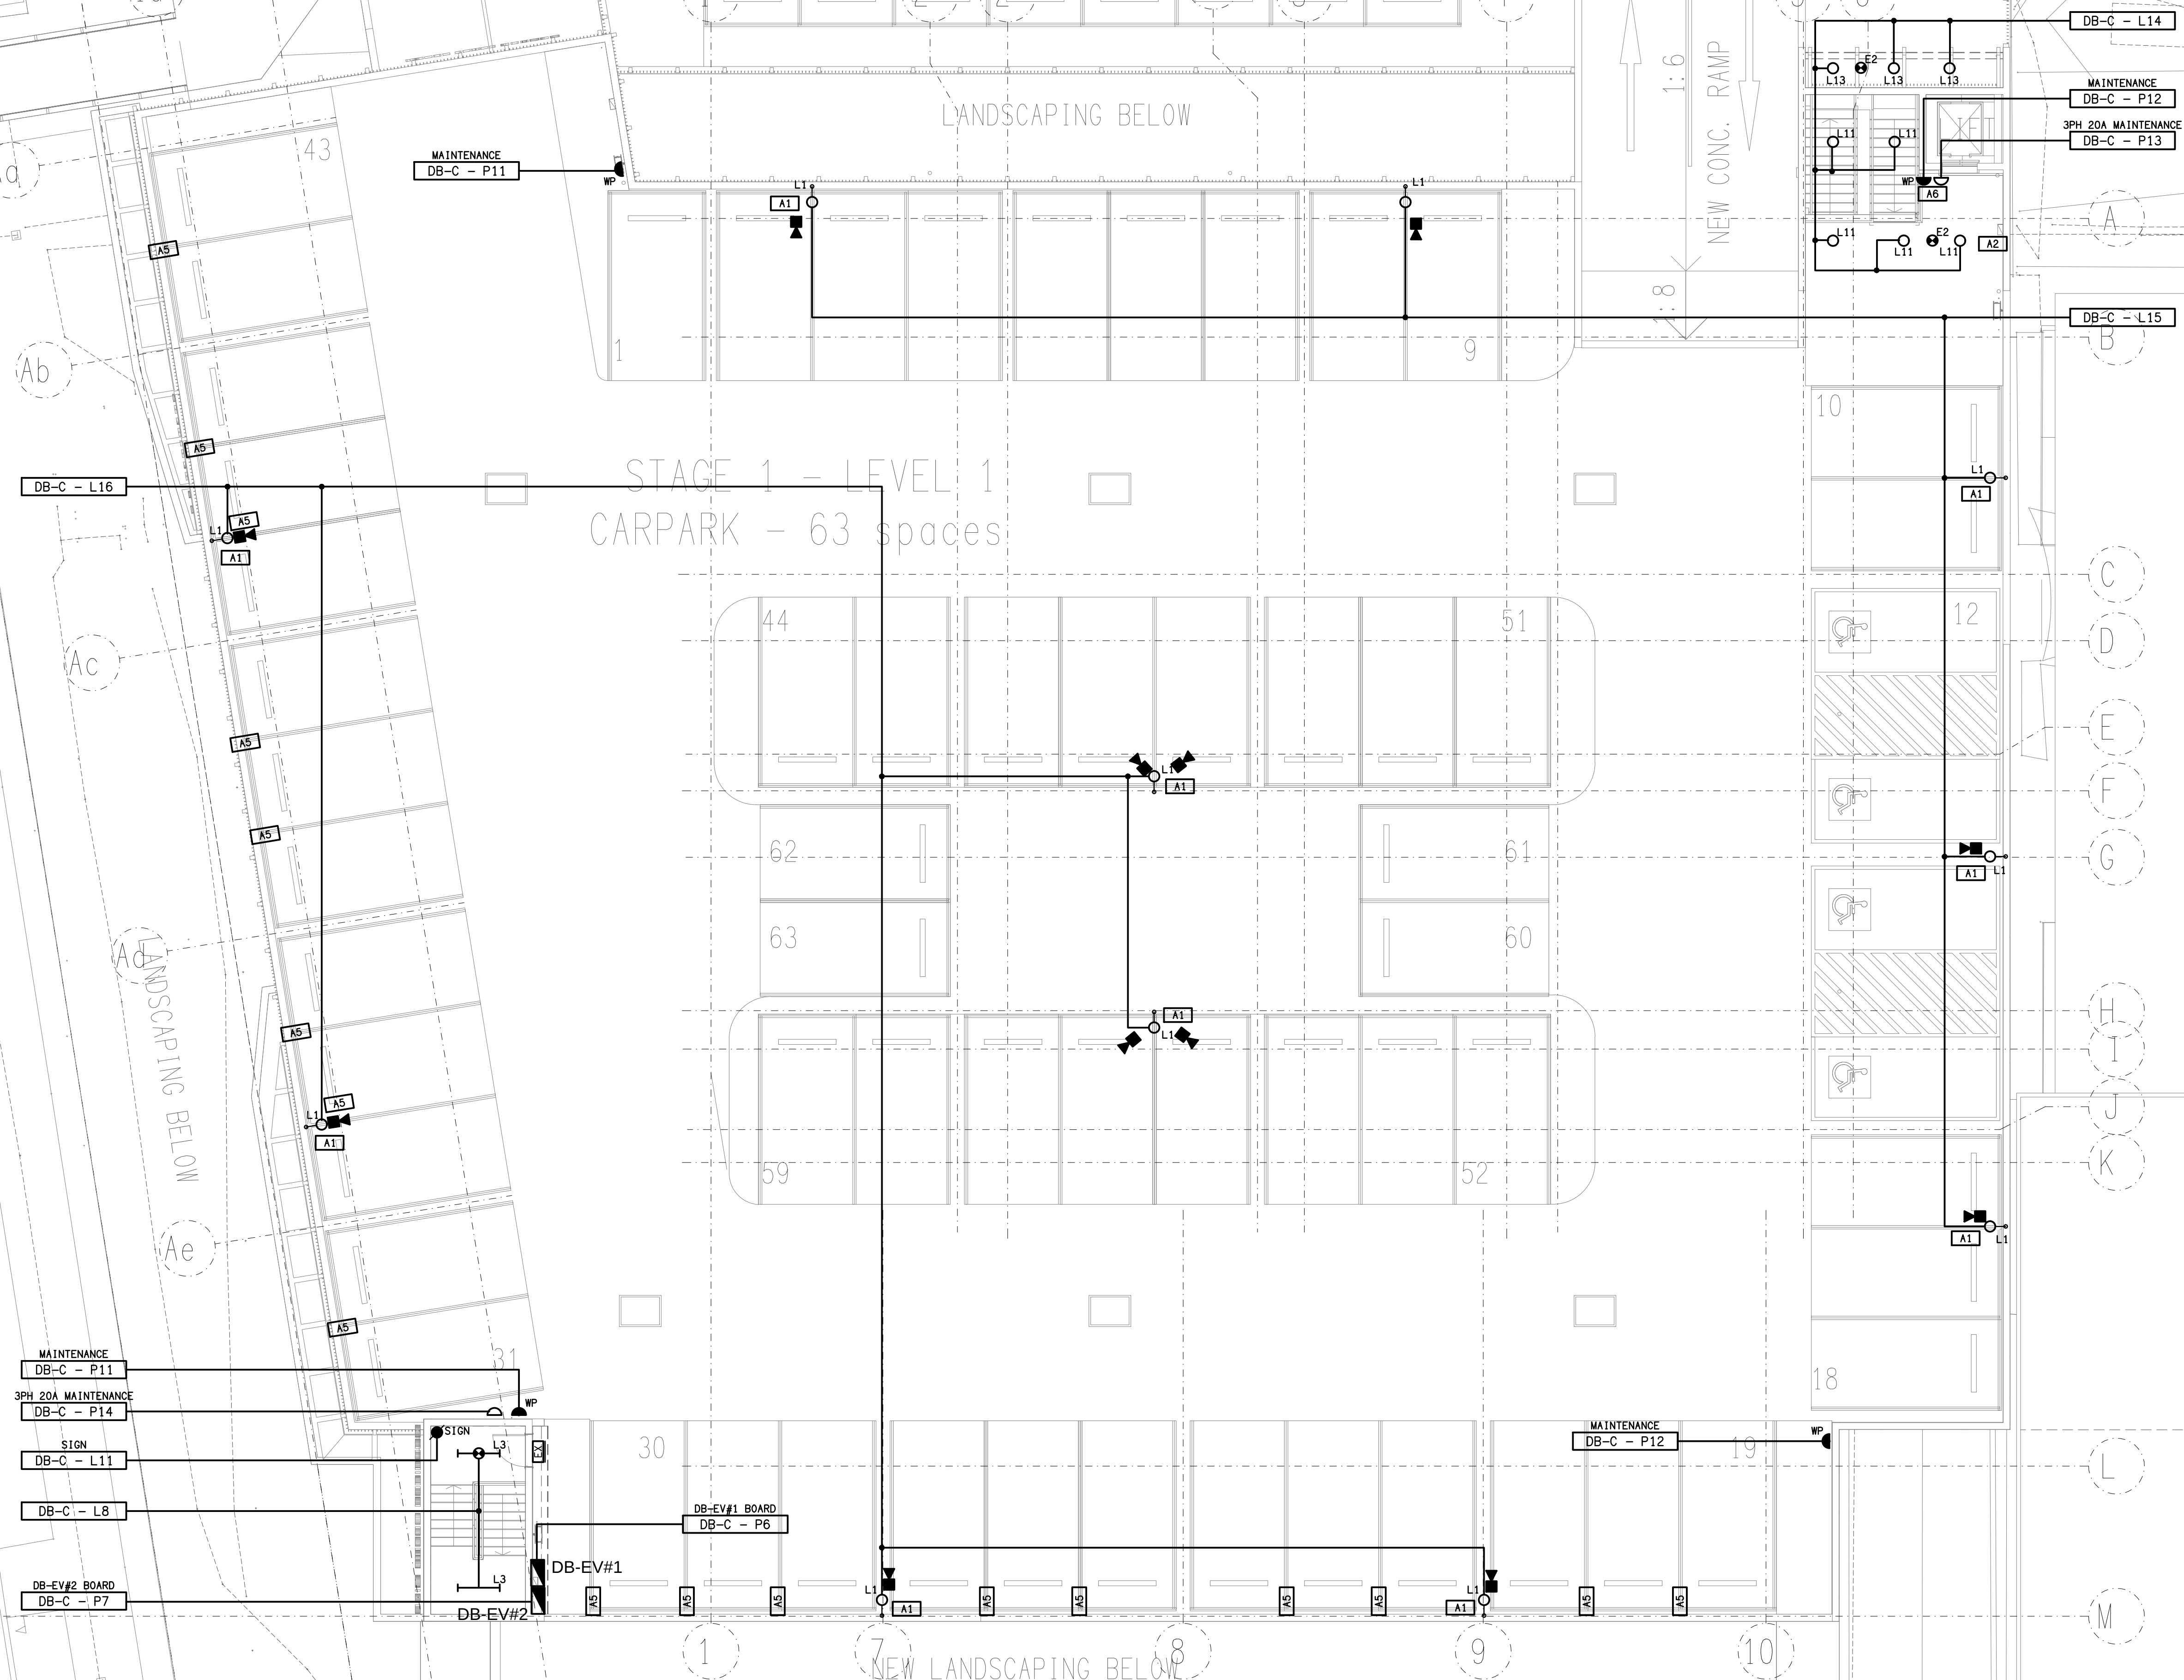

K	AS CONSTRUCTED	26/08/2026
REV:	DESCRIPTION:	DATE:

ELECTRICAL DESIGN GROUP
ELECTRICAL BUILDING SERVICES CONSULTANTS

BRISBANE: P.O. Box 15 Sherwood Qld 4075
Phone: (07) 3278 4375
Email: brisbane@edg.net.au
Web: www.edg.net.au

ELECTRICAL DESIGN GROUP BRISBANE
PTY LTD
ACN 092 710 793

TRADING AS:
ELECTRICAL DESIGN
GROUP

PROJECT: CAPALABA SPORTS CLUB
MULTI-STOREY CARPARK

SITE ADDRESS:

113 NEY ROAD, CAPALABA

SCALE:	SHEET SIZE:
1:100 UNO	AT A1

DRAWING TITLE:

ELECTRICAL SERVICES
LEVEL 1 PLAN

PROJECT NO:	DRAWING NO:	REVISION:
C3455a	E03	K