

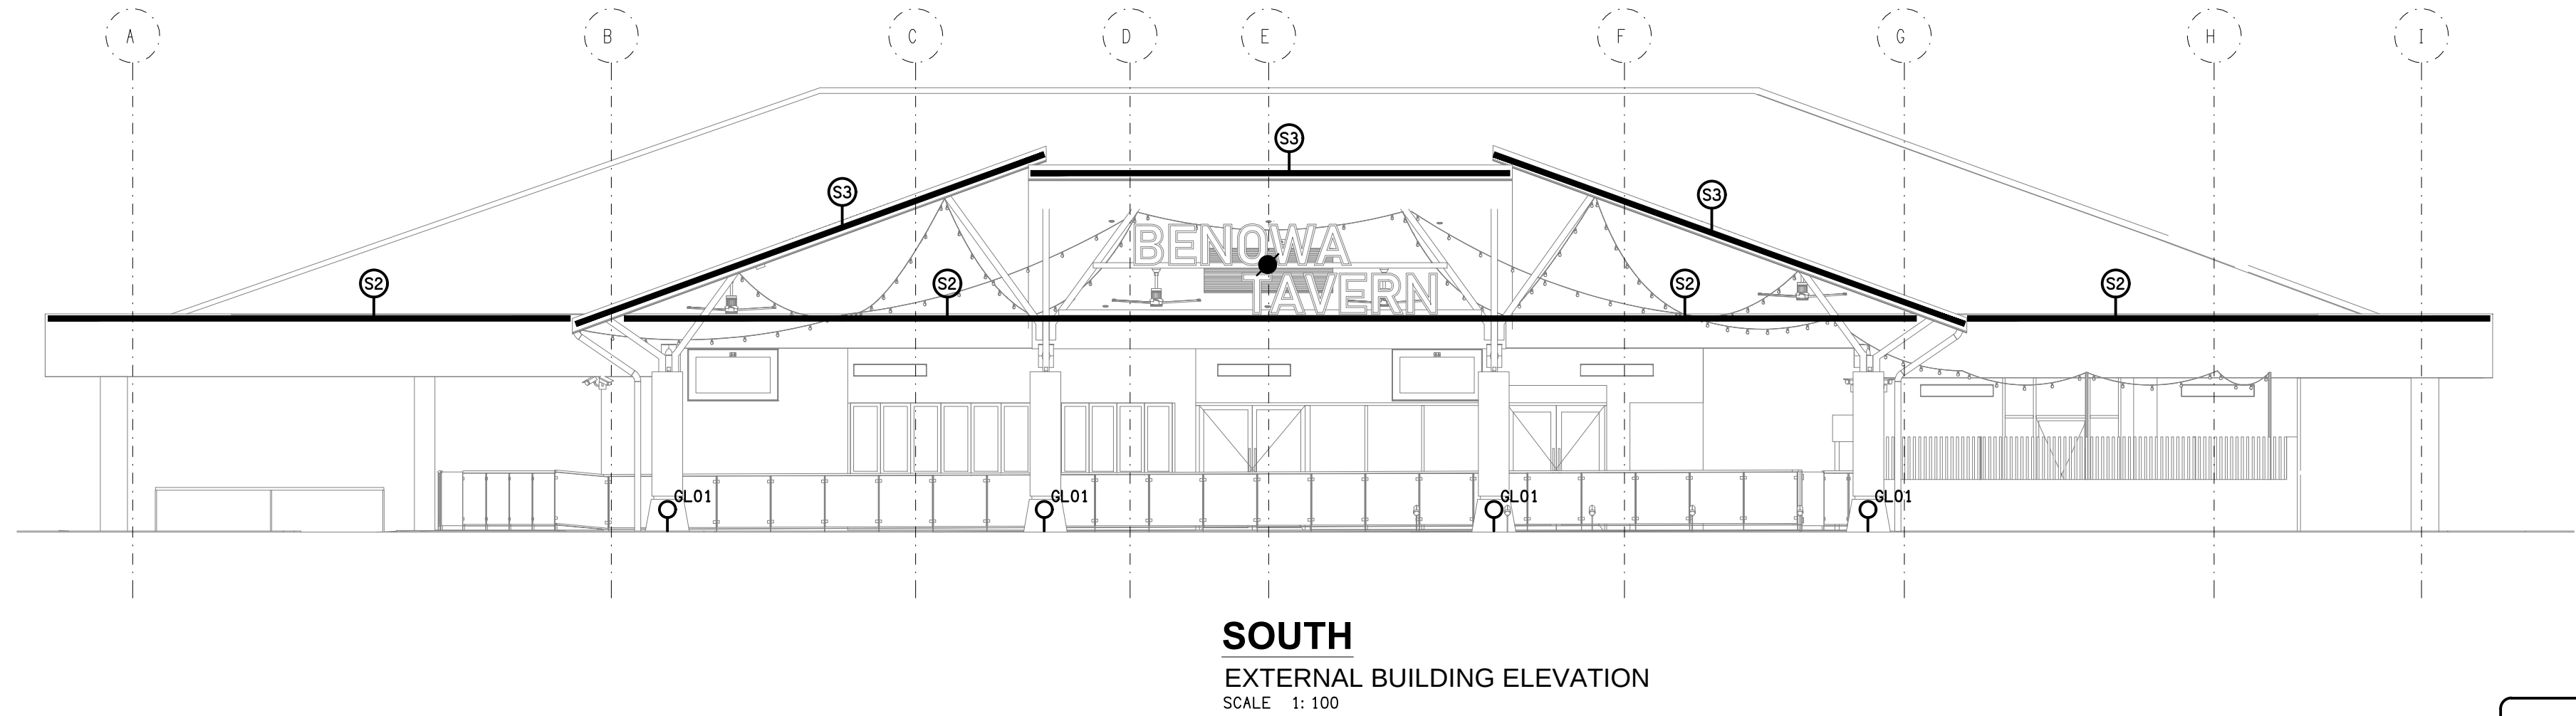


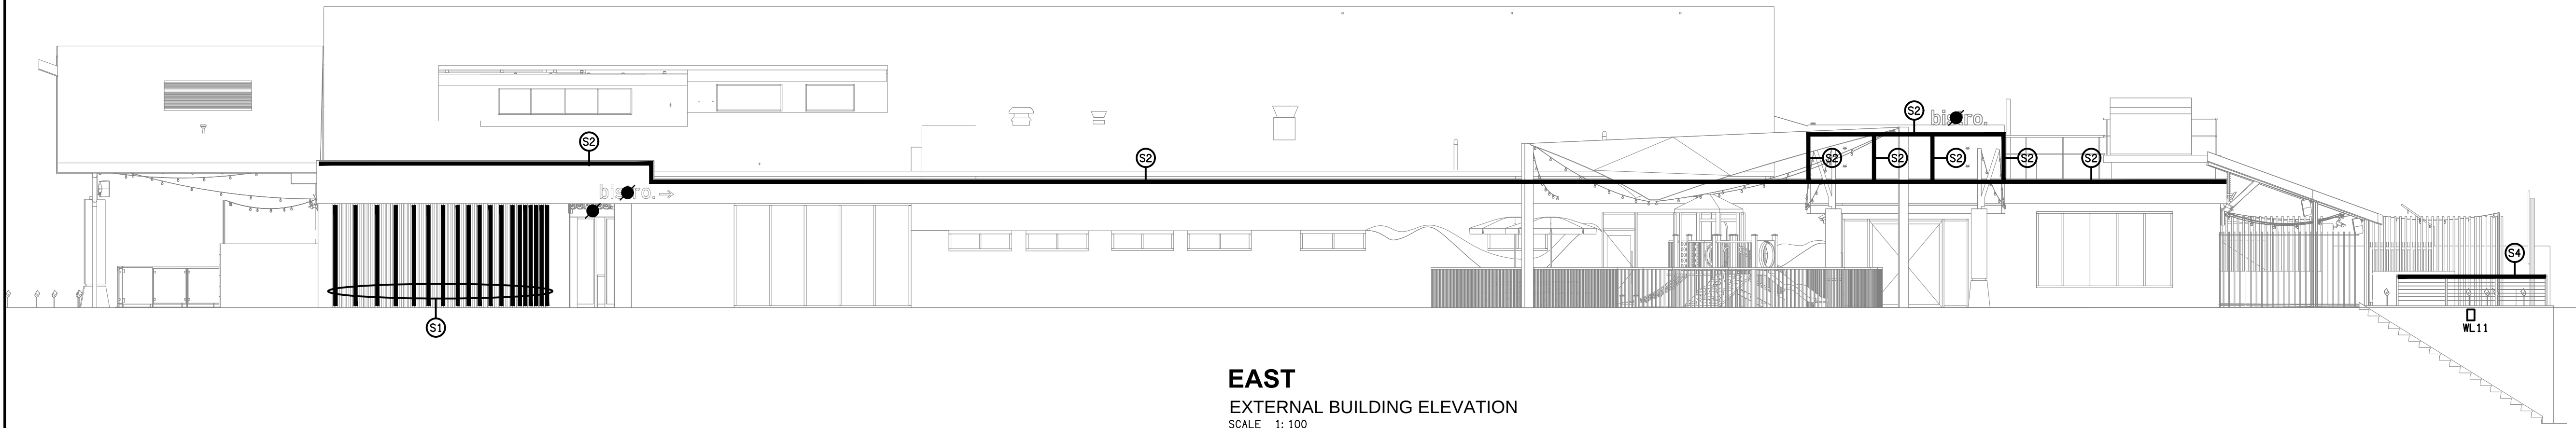

NOTE:
REFER TO DRAWINGS 3600a-E08 AND 3600a-E09
FOR THE CIRCUITS AND CHANNELS FOR THE
LIGHTS AND SIGNAGE SHOWN ON THIS PLAN.

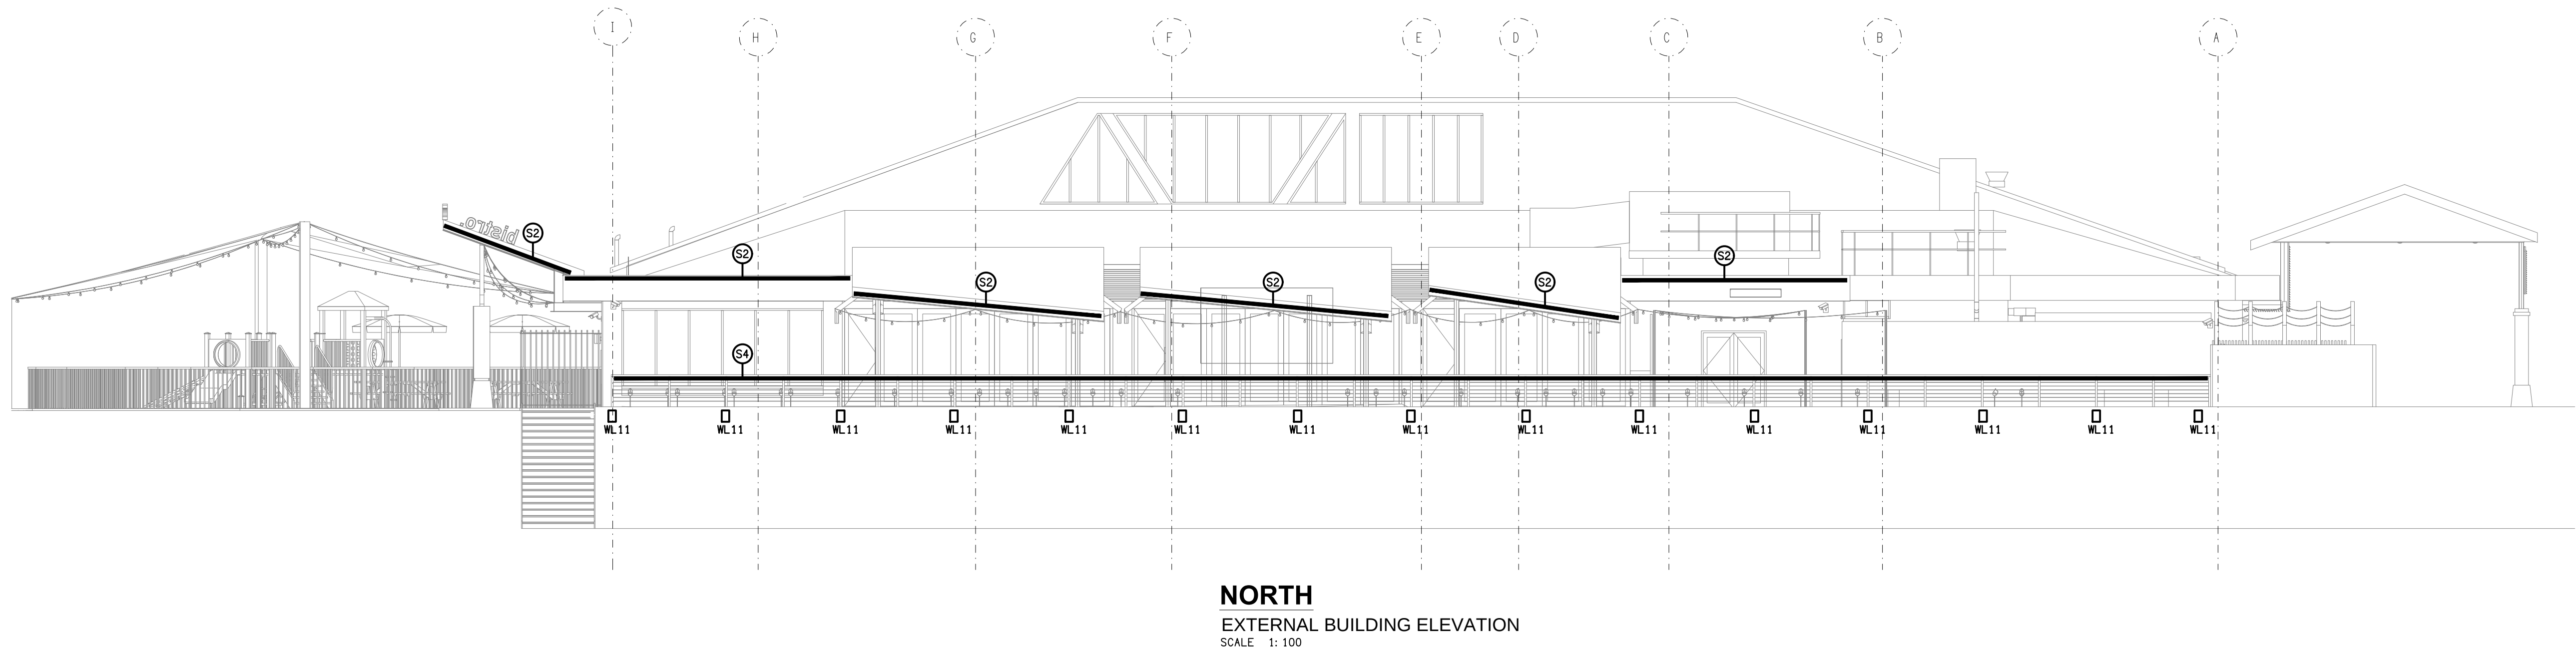

D	AS CONSTRUCTED	02/07/2026
REV:	DESCRIPTION:	DATE:

ELECTRICAL DESIGN GROUP
ELECTRICAL BUILDING SERVICES CONSULTANTS

BRISBANE: P.O. Box 15 Sherwood Qld 4075
Phone: (07) 3278 4375
Email: brisbane@edg.net.au
Web: www.edg.net.au

ELECTRICAL DESIGN GROUP BRISBANE PTY LTD
ACN 092 710 793

TRADING AS:
ELECTRICAL DESIGN
GROUP

PROJECT:
BENOWA TAVERN

SITE ADDRESS:
**117 ASHMORE ROAD, BENOWA
GOLD COAST**

SCALE: 1:100 SHEET SIZE: A1
AT

DRAWING TITLE:

**ELECTRICAL SERVICES
EXTERNAL BUILDING
ELEVATIONS**

PROJECT NO: DRAWING NO: REVISION:

C3600a E04 D