




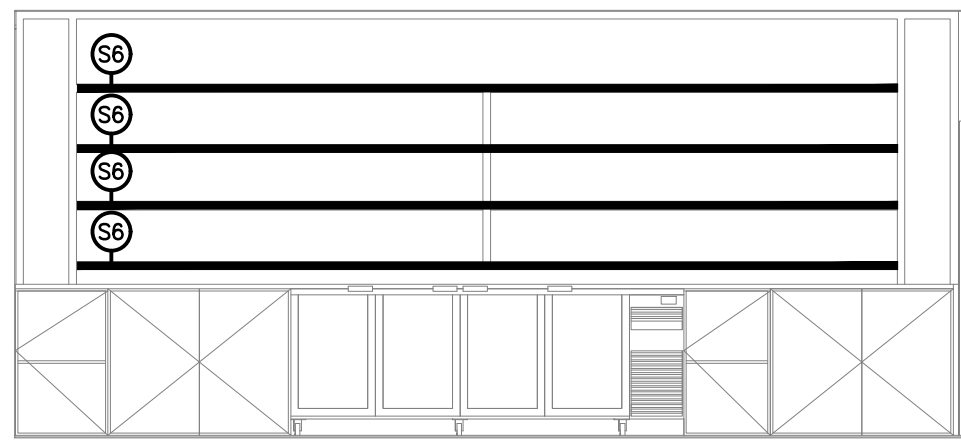


1 Lighting Elevation - Bistro
1 : 50

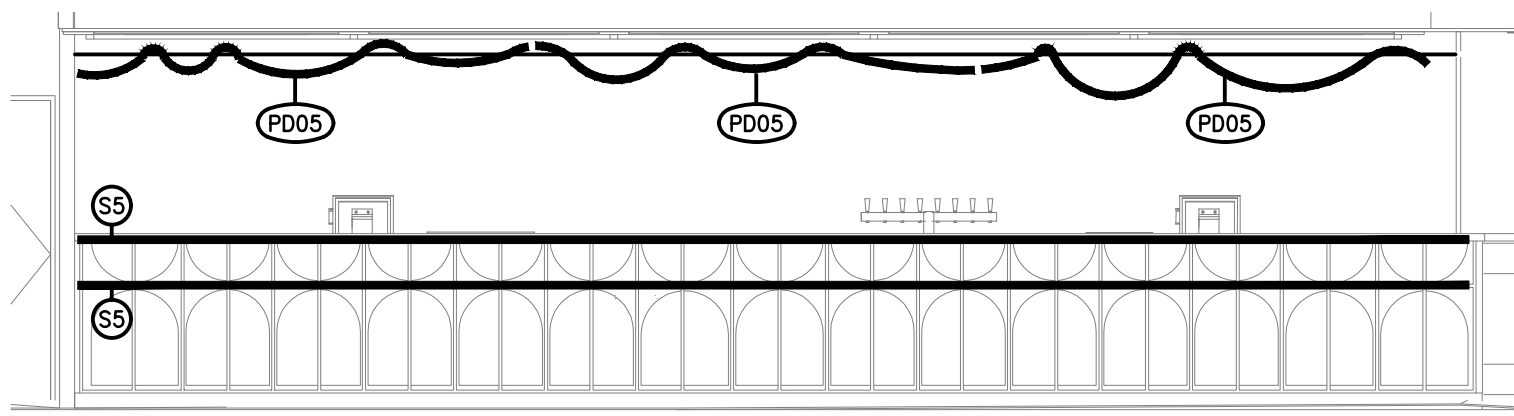


2 Lighting Elevation - Bistro
1 : 50

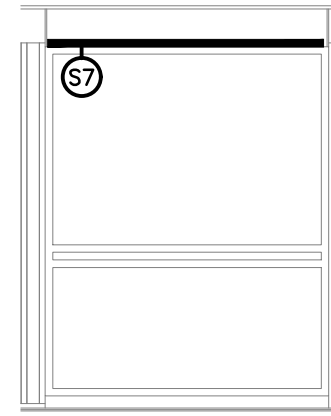


3 Lighting Elevation - Bistro
1 : 50

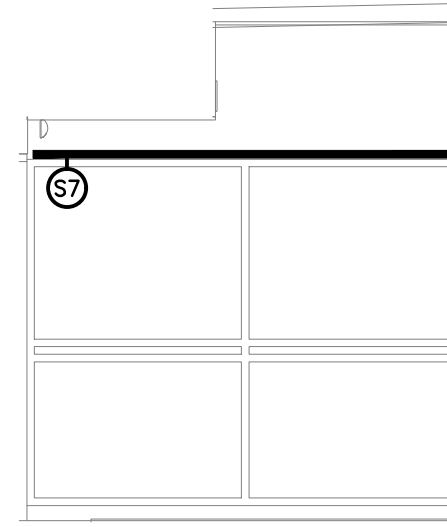

4 Lighting Elevation - Bistro
1 : 50

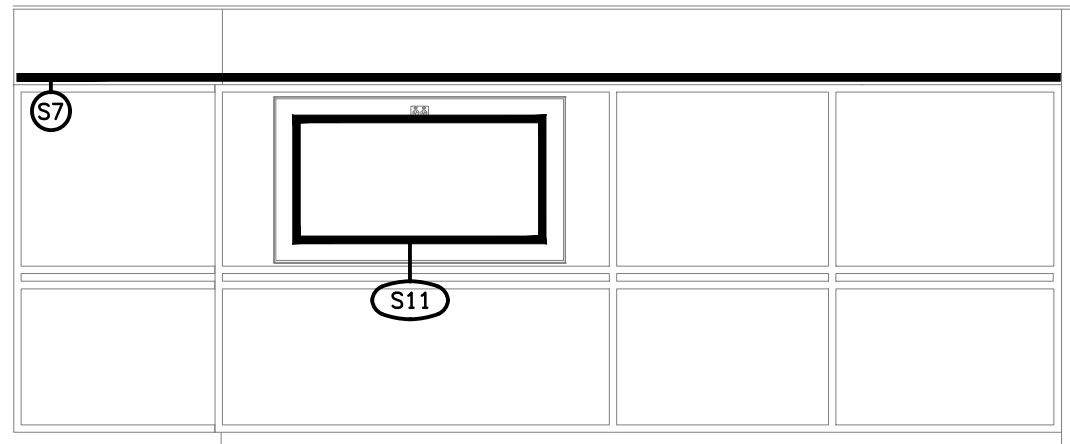


5 Lighting Elevation - Bistro
1 : 50

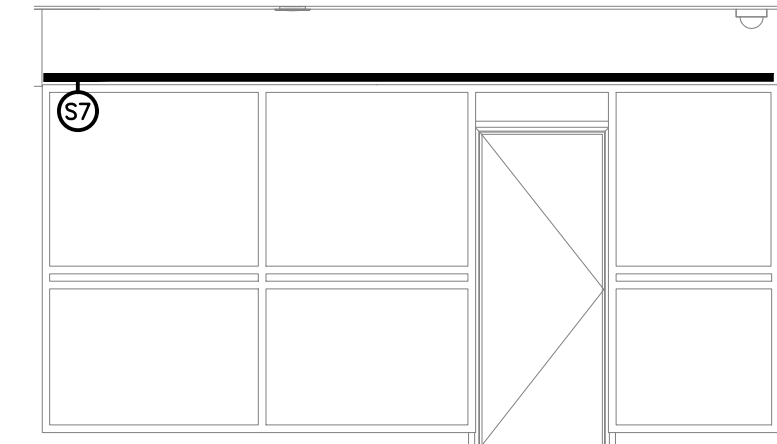


6 Lighting Elevation - Bistro
1 : 50


DETAIL (7) NO LONGER REQUIRED

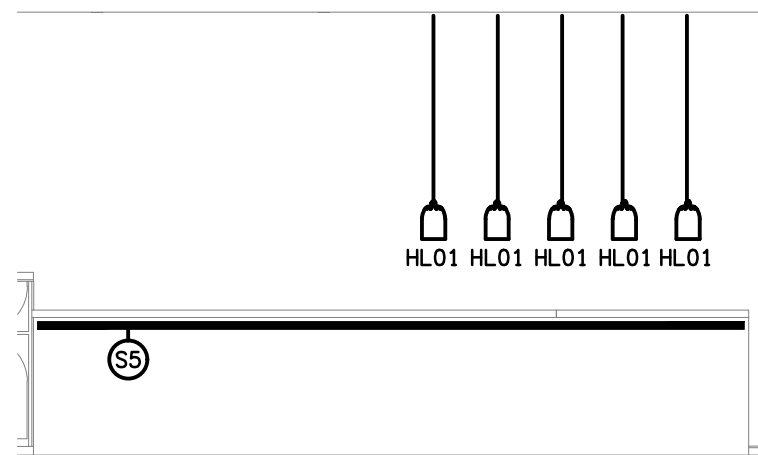


8 Lighting Elevation - Bistro
1 : 50

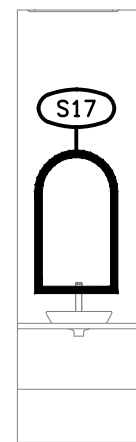


17 Lighting - Typical Mirror
1 : 50

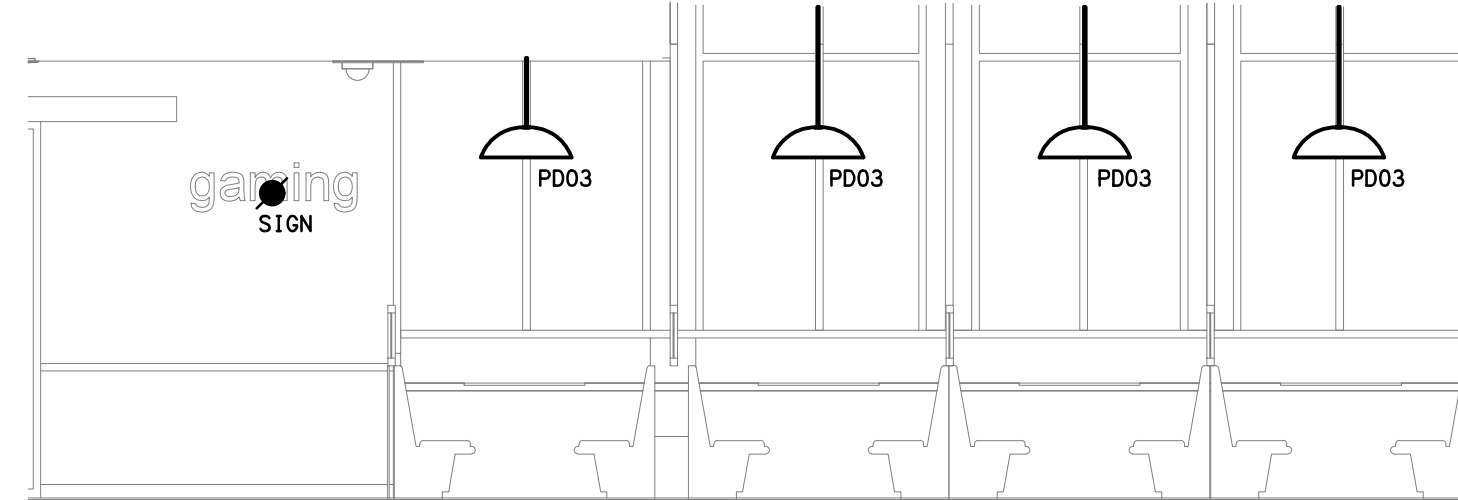


18 Lighting Elevation - Bistro
1 : 50

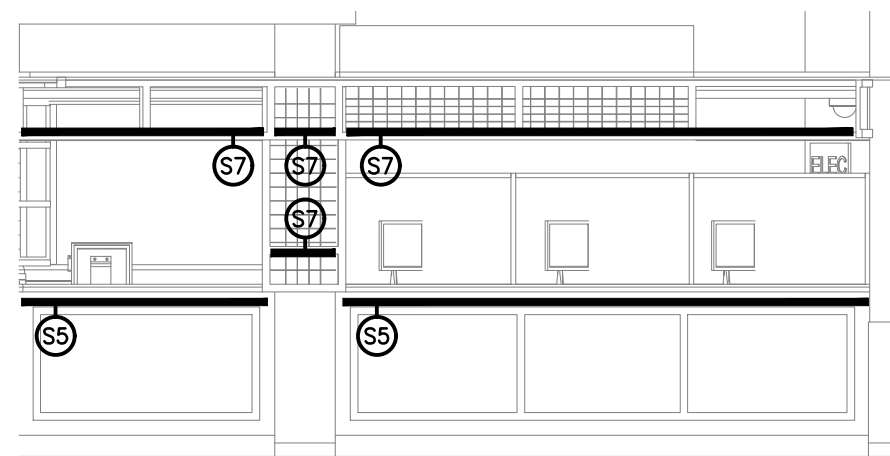


9 Lighting Elevation - Sports
1 : 50

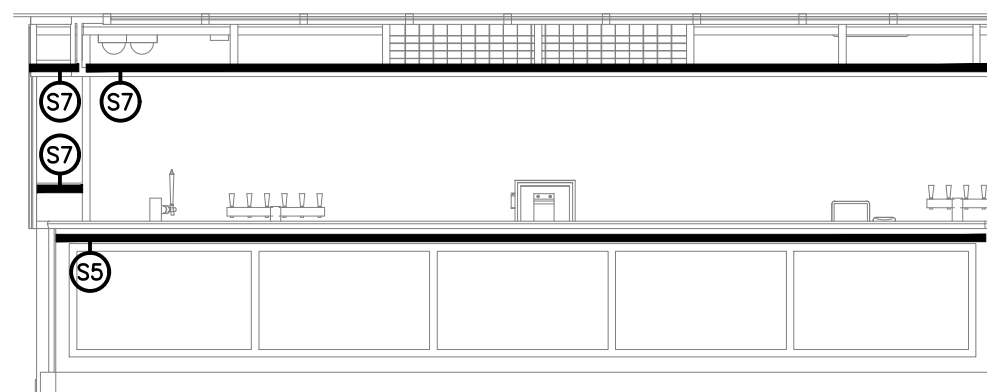


10 Lighting Elevation - Sports
1 : 50

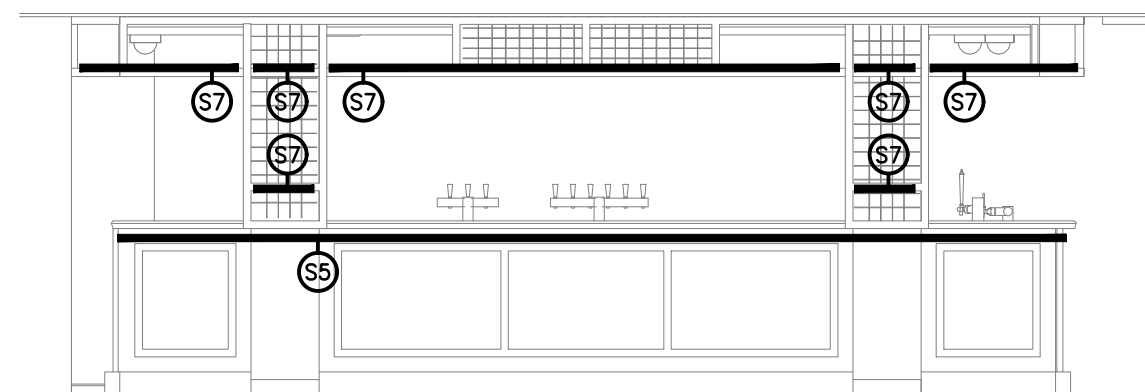


11 Lighting Elevation - Sports
1 : 50

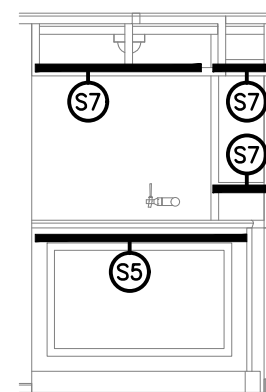


12 Lighting Elevation - Sports
1 : 50

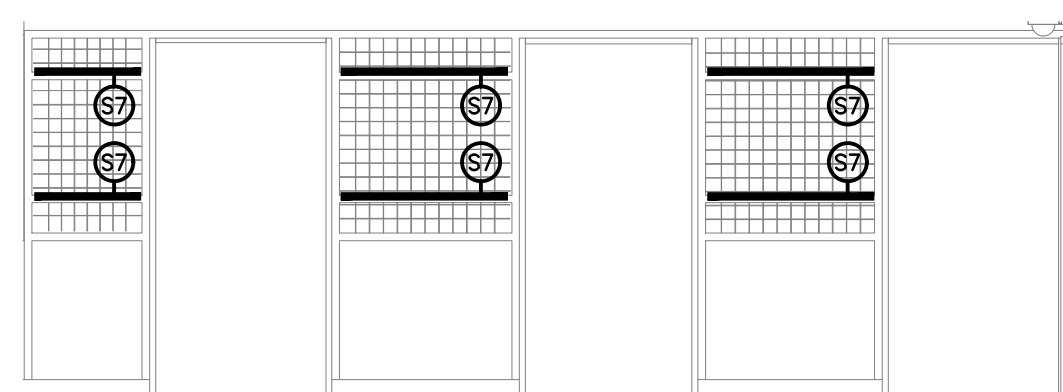


14 Lighting Elevation - Sports
1 : 50

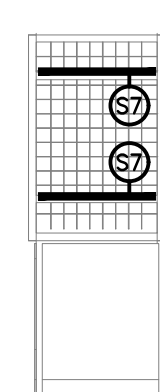

15 Elevation
1 : 50

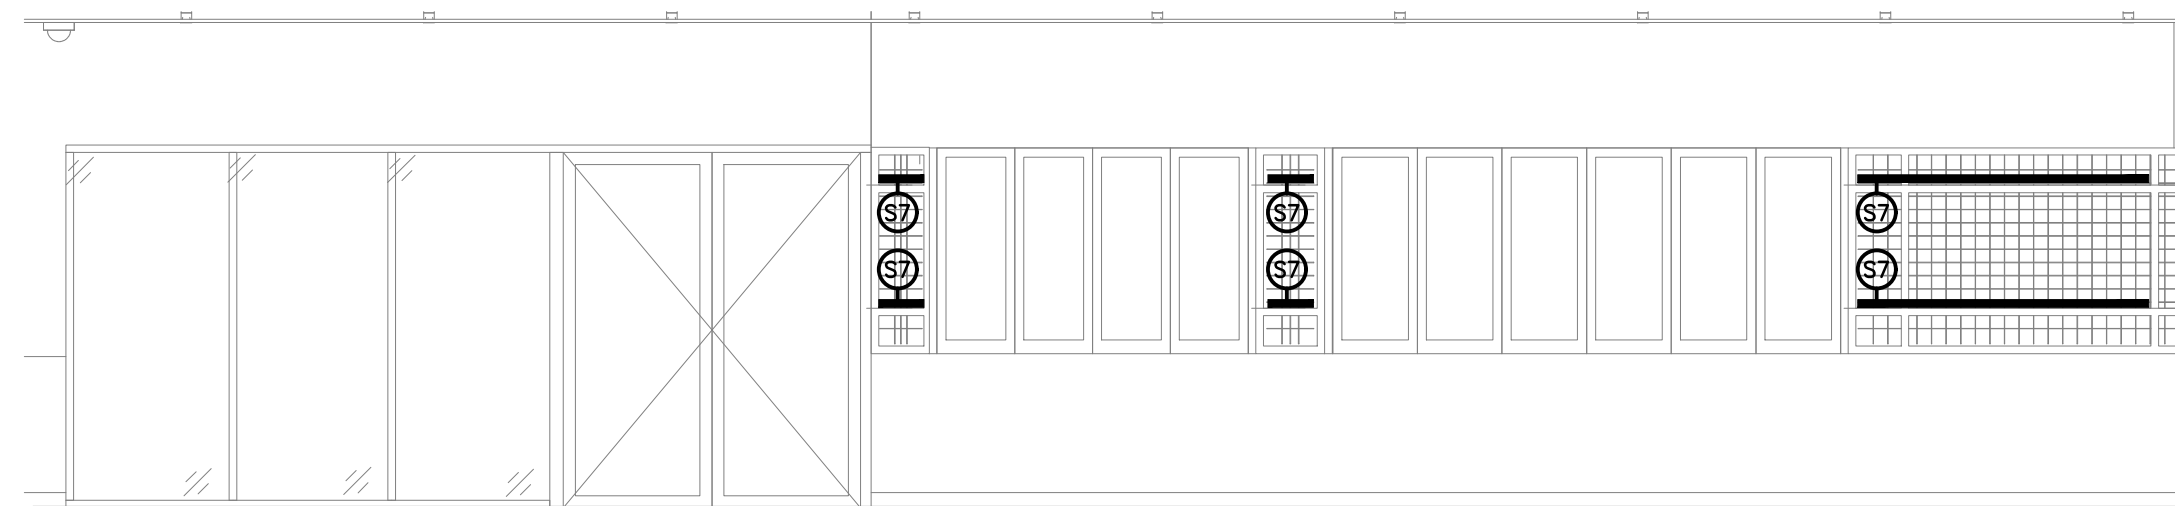

13 Lighting Elevation - Sports
1 : 50

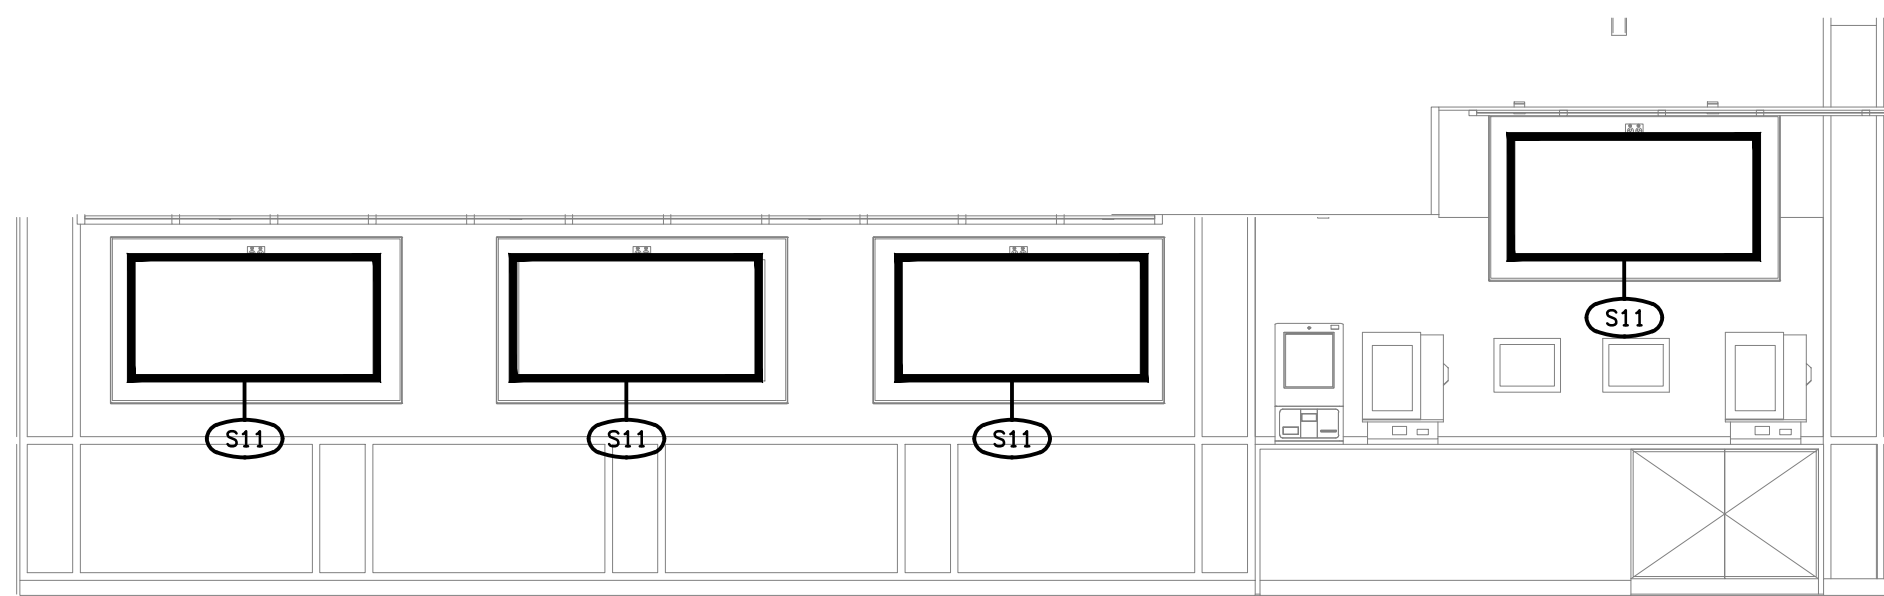

16 Lighting Elevation - Sports
1 : 50



G	AS CONSTRUCTED	02/07/2026
REV:	DESCRIPTION:	DATE:

ELECTRICAL DESIGN GROUP
ELECTRICAL BUILDING SERVICES CONSULTANTS

BRISBANE: P.O. Box 15 Sherwood Qld 4075
Phone: (07) 3278 4375
Email: brisbane@edg.net.au
Web: www.edg.net.au

ELECTRICAL DESIGN GROUP BRISBANE PTY LTD
ACN 092 710 793

TRADING AS:
ELECTRICAL DESIGN
GROUP

PROJECT:

BENOWA TAVERN

SITE ADDRESS:

**117 ASHMORE ROAD, BENOWA
GOLD COAST**

SCALE: SHEET SIZE:

1:100 AT A1

DRAWING TITLE:

**ELECTRICAL SERVICES
JOINERY & WALL
LIGHTING ELEVATIONS**

PROJECT NO: DRAWING NO: REVISION:

C3600a E11 G